

DEPARTMENT OF REGULATORY AND ECONOMIC RESOURCES (RER) BOARD AND CODE ADMINISTRATION DIVISION

PRODUCT CONTROL SECTION 11805 SW 26 Street, Room 208 Miami, Florida 33175-2474

T (786) 315-2590 F (786) 315-2599 www.miamidade.gov/economy

MIAMI-DADE COUNTY

#### NOTICE OF ACCEPTANCE (NOA)

Nan Ya Plastics Corporation USA 8989 North Loop East, Suite 800 Houston, TX 77029

#### Scope:

This NOA is being issued under the applicable rules and regulations governing the use of construction materials. The documentation submitted has been reviewed and accepted by Miami-Dade County RER -Product Control Section to be used in Miami Dade County and other areas where allowed by the Authority Having Jurisdiction (AHJ).

This NOA shall not be valid after the expiration date stated below. The Miami-Dade County Product Control Section (In Miami Dade County) and/or the AHJ (in areas other than Miami Dade County) reserve the right to have this product or material tested for quality assurance purposes. If this product or material fails to perform in the accepted manner, the manufacturer will incur the expense of such testing and the AHJ may immediately revoke, modify, or suspend the use of such product or material within their jurisdiction. RER reserves the right to revoke this acceptance, if it is determined by Miami-Dade County Product Control Section that this product or material fails to meet the requirements of the applicable building code.

This product is approved as described herein, and has been designed to comply with the Florida Building Code, including the High Velocity Hurricane Zone.

DESCRIPTION: Nan Ya "Distinction "Series Fiberglass Outswing Double glazed Doors w/wo Sidelite - N.I.

APPROVAL DOCUMENT: Drawing No. NAN0013 Rev F, titled "Distinction-Non-Impact Double", sheets 1 through 13 of 13, dated 07/25/08 and last revised on 09-11-14, prepared by PTC, LLC, signed and sealed by Robert J. Amoruso, P.E., bearing the Miami-Dade County Product Control Revision stamp with the Notice of Acceptance number and expiration date by the Miami-Dade County Product Control Section.

#### MISSILE IMPACT RATING: None.

#### Limitations:

- 1. Approved Hurricane protection Devices, complying w/ FBC, as applicable are required.
- 2. Max 14" wide side lite can be Opaque or glazed. Min 7" door panel stiles & rails required
- 3. Masonry (CMU) is only applicable at jambs.
- 4. 1x or 2x buck to be properly secured to sustain imposed load and to be reviewed by building Official.

LABELING: Each unit shall bear a permanent label with the manufacturer's name or logo, city, state and series and following statement: "Miami-Dade County Product Control Approved", unless otherwise noted herein.

RENEWAL of this NOA shall be considered after a renewal application has been filed and there has been no change in the applicable building code negatively affecting the performance of this product.

**TERMINATION** of this NOA will occur after the expiration date or if there has been a revision or change in the materials, use, and/or manufacture of the product or process. Misuse of this NOA as an endorsement of any product, for sales, advertising or any other purposes shall automatically terminate this NOA. Failure to comply with any section of this NOA shall be cause for termination and removal of NOA.

**ADVERTISEMENT:** The NOA number preceded by the words Miami-Dade County, Florida, and followed by the expiration date may be displayed in advertising literature. If any portion of the NOA is displayed, then it shall be done in its entirety.

**INSPECTION:** A copy of this entire NOA shall be provided to the user by the manufacturer or its distributors and shall be available for inspection at the job site at the request of the Building Official.

This NOA revises & renews NOA # 12-0612.04 consists of this page 1 and evidence page E-1 and E-2, as well as approval document mentioned above.

The submitted documentation was reviewed by Ishaq I. Chanda, P.E.

(MIAMI-DADE COUNTY)

NOA No. 13-1030.03 Expiration Date: November 20, 2018 Approval Date: October 02, 2014 Page 1

#### Nan Ya Plastics Corporation USA

#### NOTICE OF ACCEPTANCE: EVIDENCE SUBMITTED

#### A. DRAWINGS

- 1. Manufacturer's die drawings and sections (submitted under file #12-0612.04/ # 08-0425.11).
- 2. Drawing No. NAN0013 Rev F, titled "Distinction-Non-Impact Double", sheets 1 through 13 of 13, dated 07/25/08 and last revised on 09-11-14, prepared by PTC, LLC, signed and sealed by Robert J. Amoruso, P.E.
- **B. TESTS** (submitted under file #12-0612.04/ # 08-0425.11)
  - 1. Test reports on 1) Air Infiltration Test, per FBC, TAS 202-94
    - 2) Uniform Static Air Pressure Test, Loading per FBC TAS 202-94
    - 3) Water Resistance Test, per FBC, TAS 202-94
    - 4) Forced Entry Test, per FBC 3603.2 (b) and TAS 202-94

along with marked-up drawings and installation diagram of Fiberglass Outswing Door w/ Sidelites, prepared by ETC Laboratories, Test Report No. ETC-06-255-174121.1, dated 07/10/06, signed and sealed by Joseph L. Doldan, P.E.

Note: This test report has been revised by an addendum issued by ETC Lab on 08/21/08, signed & sealed by Joseph L. Doldan, P.E.

#### C. CALCULATIONS

- 1. Anchor verification calculations and structural analysis complying per FBC 2010, prepared by PTC Engineering, Inc., dated 08/08/14, signed and sealed by Robert J. Amoruso, P.E.
- 2. Statement letter, dated SEP 04, 2012 of test standard equivalency of plastic material conformance to FBC 2007 & 2010, prepared by PTC, LLC, signed and sealed by Robert J. Amoruso, P.E.
- 3. Glazing complies w/ ASTME-1300-02 &-04.

#### D. QUALITY ASSURANCE

1. Miami Dade Department of Regulatory and Economic Resources (RER).

### E. MATERIAL CERTIFICATIONS (submitted under file #12-0612.04/ # 08-0425.11)

- 1. Test report No.ETC-05-255-16776.1, prepared by ETC Laboratories, dated 07/06/06, issued to Nan Ya Plastics Corp., for their SMC Fiberglass material / ETC05033 per ASTMD-638-03 "4500 exposed Xenon Arch" & tensile strength ASTMD-638-03 "Tensile strength", Smoke density per ASTMD2843-99, Rate of burning per ASTMD-635-98 and "Self ignition" per ASTMD1929-01, all signed and sealed by Joseph Labora Doldan, P.E.
- 2. Test report No.ETC-05-255-17144.0, prepared by ETC Laboratories, dated 07/03/08, issued to Nan Ya Plastics Corp., for their Rigid PVC plastic( part #ETC06024) per ASTM D1929-96 "Standard Test Method for Ignition Properties of Plastics", ASTM D2843-99 "Standard Test Method for Density of Smoke from the Burning or Decomposition of Plastics", ASTM D635-98 "Standard Test Method for Rate of Burning and/or Extent and Time of Burning of Self-Supporting Plastics in a Horizontal Position" and ASTM D638-03 "Standard Test Methods for Tensile Properties of Plastics" for exposed & unexposed sample per Xenon Arch after 4500 Hours, signed and sealed by Joseph Labora Doldan, P.E.

Ishaq I. Chanda, P.E.
Product Control Examiner

NOA No 13-1030.03 Expiration Date: November 20, 218 Approval Date: October 02, 2014

E - 1

#### NOTICE OF ACCEPTANCE: EVIDENCE SUBMITTED

#### E. MATERIAL CERTIFICATIONS (continue)

- 3. Test report No.ETC-06-255-17412.0, prepared by ETC Laboratories, dated 04/25/06, issued to Nan Ya Plastics Corp., for their Phenolic Foam Board / ETC06013 plastic per ASTME-E84-05 "Standard Test Method for Surface Burning Characteristics of Building Materials", signed and sealed by Joseph Labora Doldan, P.E.
- 4. Test report No.ETC-05-255-17412.1, prepared by ETC Laboratories, dated 04/25/06, re-issued on 06/28/06 to Nan Ya Plastics Corp., for their Phenolic Foam Board / ETC06013 plastic per ASTME-E84-05 "Standard Test Method for Surface Burning Characteristics of Building Materials", signed and sealed by Joseph L. Doldan, P.E.
- 5. Test report No.ETC-05-255-17900.0, prepared by ETC Laboratories, dated 06/28/06, issued to Nan Ya Plastics Corp., for their Phenolic Foam Board / ETC06013 plastic per ASTM D1929-96 "Standard Test Method for Ignition Properties of Plastics", signed and sealed by Joseph L. Doldan, P.E.
- 6. Test report No.ETC-05-255-16776.0, prepared by ETC Laboratories, dated 01/04/06, issued to Nan Ya Plastics Corp., for their SMC / ETC05033 plastic per ASTM D1929-96 "Standard Test Method for Ignition Properties of Plastics", ASTM D2843-99 "Standard Test Method for Density of Smoke from the Burning or Decomposition of Plastics", ASTM D635-98 "Standard Test Method for Rate of Burning and/or Extent and Time of Burning of Self-Supporting Plastics in a Horizontal Position" and ASTM D638-03 "Standard Test Methods for Tensile Properties of Plastics", signed and sealed by Joseph Labora Doldan, P.E.
- 7. Test report No.ETC-05-255-16777.1, prepared by ETC Laboratories, dated 07/26/06, issued to Nan Ya Plastics Corp., for their Cellular PVC / ETC05034 plastic per ASTM D1929-96 "Standard Test Method for Ignition Properties of Plastics", ASTM D2843-99 "Standard Test Method for Density of Smoke from the Burning or Decomposition of Plastics", ASTM D635-98 "Standard Test Method for Rate of Burning and/or Extent and Time of Burning of Self-Supporting Plastics in a Horizontal Position" and ASTM D638-03 "Standard Test Methods for Tensile Properties of Plastics", signed and sealed by Joseph Labora Doldan, P.E.

#### F. STATEMENTS

- 1. Statement letter of compliance to FBC 2010 & FBC 2007 and "No financial interest" dated 09/23/2014, prepared by PTC, LLC, signed and sealed by Robert J. Amoruso, P.E.
- 2. Certificate of Authority dated May 23, 1983, to transact business, issued to Nan Ya Plastic Corporation, USA issued by the State of Texas, signed by Secretary of State.
- 3. Lab compliance letter as part of above test reports.

#### G. OTHER

- 1. This NOA revises & renews NOA # 12-0612.04, expired on November 20, 2013.
- 2. Test proposal # **06-1291** dated 11/06/2006 approved by BCCO.

Ishaq I. Chanda, P.E. Product Control Examiner NOA No. 13-1030.03

Expiration Date: November 20, 2018 Approval Date: October 02, 2014

# NAN YA PLASTICS CORP. DISTINCTION NON-IMPACT DOUBLE ENTRY O.S. DOOR WITH AND WITHOUT SIDELIGHTS INSTALLATION ANCHORAGE DETAILS

#### **GENERAL NOTES:**

- 1. THE PRODUCT ANCHORAGE SHOWN HEREIN IS DESIGNED
  TO COMPLY WITH THE CURRENT EDITION OF THE
  FLORIDA BUILDING CODE (FBC), AT THE DESIGN
  PRESSURES STATED HEREIN.
- 2. THE PRODUCT DETAILS CONTAINED HEREIN ARE BASED UPON SIGNED AND SEALED TEST REPORT #ETC-07-255-18448.4, AND ASSOCIATED LABORATORY STAMPED DRAWINGS.
- 3. THE PRODUCT HAS BEEN EVALUATED FOR CONFORMANCE TO THE STANDARDS LISTED IN THE CURRENT EDITION OF THE FLORIDA BUILDING CODE (FBC) AND IS IN COMPLIANCE WITH SAID STANDARDS.
- 4. ADEQUACY OF THE EXISTING STRUCTURAL CONCRETE / MASONRY AND WOOD FRAMING AS A MAIN WIND FORCE RESISTING SYSTEM CAPABLE OF WITHSTANDING AND TRANSFERRING APPLIED PRODUCT LOADS TO THE FOUNDATION IS THE RESPONSIBILITY OF THE PROJECT ENGINEER OR ARCHITECT OF RECORD.
- 5. 1X AND 2X BUCKS (WHEN USED) SHALL BE DESIGNED AND ANCHORED TO PROPERLY TRANSFER ALL LOADS TO THE STRUCTURE. BUCK DESIGN AND INSTALLATION IS THE RESPONSIBILITY OF THE PROJECT ENGINEER OR ARCHITECT OF RECORD.
- 6. THE INSTALLATION DETAILS DESCRIBED HEREIN ARE GENERIC AND MAY NOT REFLECT ACTUAL CONDITIONS FOR A SPECIFIC SITE. IF SITE CONDITIONS CAUSE INSTALLATION TO DEVIATE FROM THE REQUIREMENTS DETAILED HEREIN, THEN THE BUILDING OFFICIAL MAY ELECT ONE OF THE FOLLOWING OPTIONS:
- A.OUTSIDE HVHZ: REQUIRE THAT A LICENSED ENGINEER OR ARCHITECT PREPARE AND SUBMIT SITE SPECIFIC DOCUMENTS FOR USE WITH THIS DOCUMENT TO BE REVIEWED BY AUTHORITY HAVING JURISDICTION (AHJ).
- B. INSIDE HVHZ: REQUIRE THAT A ONE-TIME SITE SPECIFIC APPROVAL BE APPLIED FOR AND OBTAINED FROM THE MIAMI-DADE COUNTY PRODUCT CONTROL SECTION.

- 7. IN HVHZ AREAS, USE OF AN APPROVED IMPACT
  PROTECTIVE SYSTEM COMPLYING WITH THE HVHZ
  REQUIREMENTS OF THE CURRENT EDITION OF THE
  FLORIDA BUILDING CODE IS MANDATORY FOR THE
  PRODUCT HEREIN. OUTSIDE HVHZ: PROTECTIVE SYSTEM
  PER THE CURRENT EDITION OF THE FLORIDA BUILDING
  CODE FOR OPENING PROTECTION WHERE APPLICABLE.
- 8. DOOR FRAME AND PANEL FRAME MATERIAL: PVC DOOR AND SIDELITE SKIN MATERIAL: FIBERGLASS
- 9. GLASS MEETS THE REQUIREMENTS OF ASTM E1300-04e1 GLASS CHARTS. SEE SHEET 4 AND 5 FOR GLAZING DETAILS.
- 10. DOOR CONSTRUCTION: FIBERGLASS SKIN WITH POLYURETHANE FOAM CORE
- 11. A 1/3 INCREASE IN ALLOWABLE STRESS FOR WIND LOADS WAS NOT USED IN THE DESIGN OF THE PRODUCT(S) SHOWN HEREIN,
- 12. ACTIVE AND INACTIVE DOOR PANELS CAN BE GLAZED USING GLAZING DETAIL A ON SHEET 4 OR GLAZING DETAIL B ON SHEET 5. SIDE LIGHTS ARE GLAZED USING GLAZING DETAIL B ON SHEET 5 OR OPAQUE (DETAIL M, N AND O ON SHEET 6; DETAIL K AND L ON SHEET 9).
- 12. IN ACCORDANCE WITH THE CURRENT EDITION OF THE FLORIDA BUILDING CODE, WOOD BUCKS SHALL HAVE BEEN PRESERVATIVE TREATED OR SHALL BE OF A DURABLE SPECIES.

#### INSTALLATION NOTES:

- 1. ONE (1) INSTALLATION ANCHOR IS REQUIRED AT EACH ANCHOR LOCATION SHOWN.
- 2. THE NUMBER OF INSTALLATION ANCHORS DEPICTED IS THE MINIMUM NUMBER OF ANCHORS TO BE USED FOR PRODUCT INSTALLATION.
- 3. SHIM AS REQUIRED AT EACH INSTALLATION ANCHOR WITH LOAD BEARING SHIM. MAXIMUM ALLOWABLE SHIM SIZE OF 1/4 INCH. SHIM WHERE SPACE OF 1/16 INCH OR GREATER OCCURS. SHIM SHALL BE CONSTRUCTED OF HIGH DENSITY PLASTIC OR BETTER.
- 4. FOR INSTALLATION INTO WOOD FRAMING, USE #12 WOOD SCREWS OF SUFFICIENT LENGTH TO ACHIEVE 1-1/2 INCH MINIMUM EMBEDMENT, 7/8" MINIMUM EDGE DISTANCE AND 7/8" MINIMUM ANCHOR SEPARATION.
- 5. FOR INSTALLATION THROUGH 1X BUCK TO CONCRETE AND/OR MASONRY (JAMBS ONLY) OR DIRECTLY INTO CONCRETE AND/OR MASONRY (JAMBS ONLY), USE 1/4 INCH ITW ADVANCED THREADFORM TAPCONS OF SUFFICIENT LENGTH TO ACHIEVE 1-1/2 INCH MINIMUM EMBEDMENT INTO CONCRETE AND 1 INCH MINIMUM EMBEDMENT INTO MASONRY (JAMBS ONLY). EDGE DISTANCE SHALL BE1-1/2 INCH MINIMUM FOR CONCRETE AND 2 INCHES MINIMUM FOR MASONRY (JAMBS ONLY). MINIMUM ANCHOR SEPARATION IS 4 INCHES FOR CONCRETE AND MASONRY INSTALLATION.
- 6. ALTERNATE CONCRETE AND/OR MASONRY INSTALLATION ANCHORS OF EQUIVALENT PERFORMANCE CHARACTERISTICS CAN BE USED UPON APPROVAL OF THE ARCHITECT OR ENGINEER OF RECORD FOR THE PROJECT OF INSTALLATION AND AS FOLLOWS:
- 6.1. OUTSIDE THE HVHZ TO BE REVIEWED BY THE BUILDING OFFICIAL.
- 6.2. INSIDE THE HVHZ REQUIRES ONE-TIME APPROVAL BY MIAMI-DADE COUNTY.
- 7. MINIMUM EMBEDMENT AND EDGE DISTANCE EXCLUDE WALL FINISHES (INCLUDING BUT NOT LIMITED TO STUCCO, FOAM, BRICK VENEER, AND SIDING), NOT PART OF THIS APPROVAL.
  - DESIGN PRESSURE RATING (PSF)

    WATER INFILTRATION REQUIRED

    ±50.0


    WATER INFILTRATION NOT REQUIRED


    ±50.0


- INSTALLATION ANCHORS AND ASSOCIATED HARDWARE MUST BE MADE OF CORROSION RESISTANT MATERIAL OR HAVE A CORROSION RESISTANT COATING.
- FOR HOLLOW BLOCK AND GROUT FILLED BLOCK, DO NOT INSTALL INSTALLATION ANCHORS INTO MORTAR JOINTS. EDGE DISTANCE IS MEASURED FROM FREE EDGE OF BLOCK OR EDGE OF MORTAR JOINT INTO FACE SHELL OF BLOCK.
- 10. INSTALLATION ANCHORS SHALL BE INSTALLED IN ACCORDANCE WITH ANCHOR MANUFACTURER'S INSTALLATION INSTRUCTIONS, AND ANCHORS SHALL NOT BE USED IN SUBSTRATES WITH STRENGTHS LESS THAN THE MINIMUM STRENGTH SPECIFI ED BY THE ANCHOR MANUFACTURER BELOW.
- 11. INSTALLATION ANCHOR CAPACITIES FOR PRODUCTS HEREIN ARE BASED ON SUBSTRATE MATERIALS WITH THE FOLLOWING PROPERTIES:
- A. WOOD MINIMUM SPECIFIC GRAVITY OF 0.55.
  B. CONCRETE -MINIMUM COMPRESSIVE STRENGTH OF 2500 PSI.
  - C. MASONRY STRENGTH CONFORMANCE TO ASTM C-90, MEDIUM WEIGHT (DENSITY > 117 PCF).

	TABLE OF CONTENTS
SHEET	SHEET DESCRIPTION
1	GENERAL AND INSTALLATION NOTES
2	ELEVATIONS
3	ANCHOR LAYOUTS
4	VERTICAL SECTIONS AND GLAZING DETAIL
5	VERTICAL SECTIONS AND GLAZING DETAIL
6	VERTICAL SECTIONS
7	VERTICAL SECTIONS
8	HORIZONTAL SECTIONS
9	HORIZONTAL SECTIONS
10	HORIZONTAL SECTIONS
11	BILL OF MATERIALS
12	COMPONENTS
13	END CONNECTION DETAILS

The state of the s	A P AV NAN	NAN YA PLASTICS CORP.	·		PPO IECT NO 413-0704	704	
Ro	H120N 6868	8989 NORTH LOOP EAST					
	NOTSUOH	HOUSTON, TX 77029		ü	DEED MD DEI DATED 09/11/14   09/11/14   R.IA	09/11/14	4
t J	DISTINCTION DBL NON-IMPACT ENTRY O.S. DOOR W & W/O SIDELITES	NTRY O.S. DOOF	W & W/O SIDELITES	<b>L</b>		1171	w. ,
E. I	GENERAL AND ANCHOR NOTES	ANCHOR NOTE	S	ı		1 1100100	×1 C
	ARED 6Y:	DRAWN BY:	DATE: 07/05/00	П	PER MD RFI DATED 11/13/13   06/06/14   N.J.A.	00/00/ 14	5
SV.			0//23/00				
9752 9752 AA		SCALE: N.T.S.	DRAWNING NO: NANO013	Ω	APPLICATION FOR RENEWAL 09/09/13 RJA NO DRAWING CHANGES	09/09/13	Ş
ř.E.	PRODUCT DESIGN GROUP, LLC Phone: 321,890,1788 PO BOX \$20775 CNGWOOD, FLORIDA 32722 Fract 321,890,1789 FRPE CA. NO. 25835 Email: Wo@ptc-corp.com	REV: F	SHEET: 1 OF 13	REV	DESCRIPTION	DATE	Ճ
7,11111111							

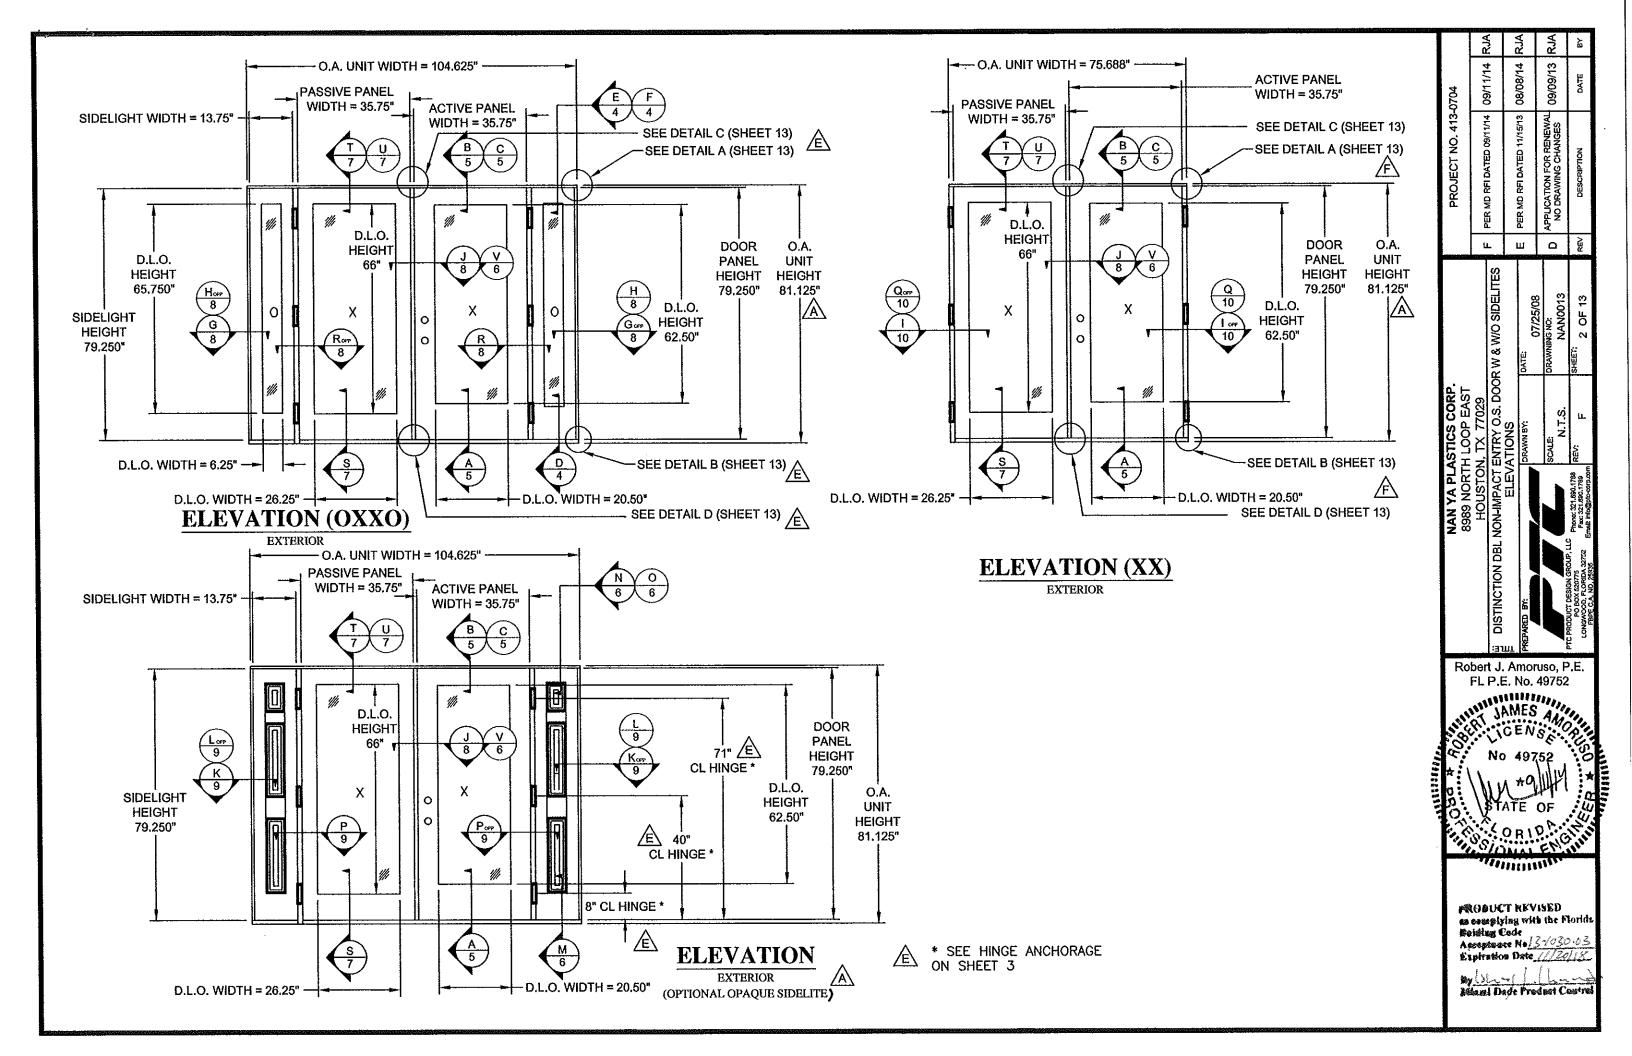

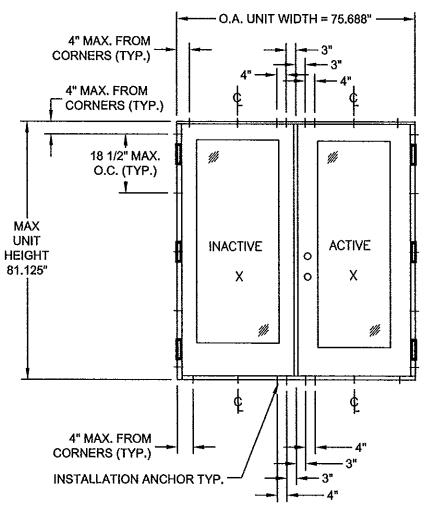

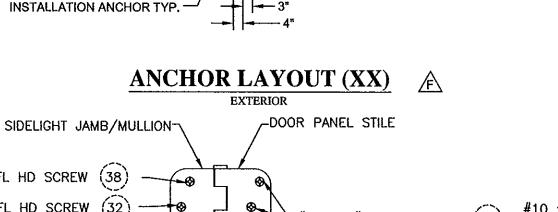


# #10 x 1 1/2" FL HD SCREW (32) **HINGE ANCHORAGE OXXO**

#10 x 3" FL HD SCREW (38)

#10 x 3" FL HD SCREW (38)

#10 x 1 1/2" FL HD SCREW (32)

SIDELIGHT JAMB/MULLION AND DOOR PANEL STILE

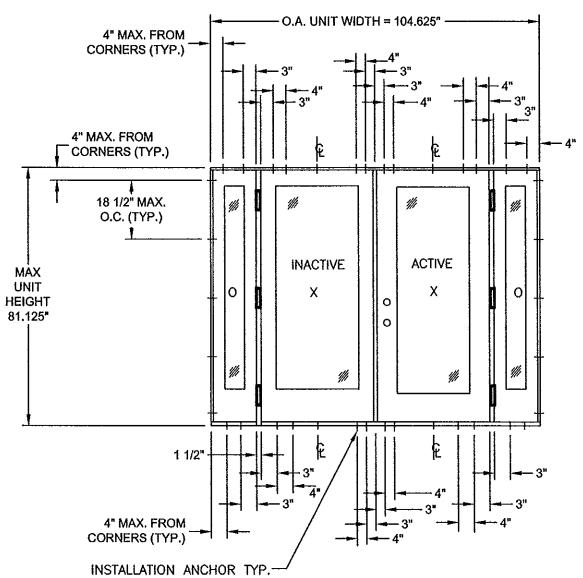

# **ANCHOR LAYOUT (OXXO)**

EXTERIOR -DOOR PANEL STILE FRAME JAMB-#10 x 2" FL HD SCREW (37) #10 x 1 1/2" FL HD SCREW (32)  $\#10 \times 2$ " FL HD SCREW (37)

## **HINGE ANCHORAGE XX**

FRAME JAMB AND DOOR PANEL STILE

Ro	NAN YA PLA 8989 NORTI	NAN YA PLASTICS CORP. 8989 NORTH LOOP EAST			PROJECT NO. 413-0704	-0704	
10	HOUSTON	HOUSTON, TX 77029		L	A MAN CONTRACTOR CONTRACTOR	A 21 A 21 O O	2
f .I		ENTRY O.S. DOOF	W & W/O SIDELITES	_	F FER WID KFI DATED VSI 1 1 14 DSI 1 1 14 DSI	41 // 1/60	707
۸.	ANCHOR	ANCHOR LAYOUTS					:
22.02	PREPARED BY:	DRAWN BY:	DATE:	П	E PER MD RFI DATED 11/15/13   08/08/14   KJA	08/08/14	Ϋ́
			01/23/00				
~~		SCALE	DRAWNING NO:	2	APPLICATION FOR RENEWAL DOVING 12 IA	09/09/13	Z. G
D	Oll allow Nestern Tolling	N.T.S.	NAN0013	,	NO DRAWING CHANGES	2000	
E	Phone: 221.690.1738 PO BOX 620775 LONGWOOD, FLOREM 27722 Fee: 231.690.1739 Fee: 271.690.1739 Fee: 271.	REV: F	SHEET: 3 OF 13	REV	DESCRIPTION	DATE	β¥


Robert J. Amoruso, P.E.


"INSTONALE


PROBUCT KEVISED so complying with the Florida Building Code Acceptance Ho 13-10


Marel Dady Preduct Centre


Expiration Date //

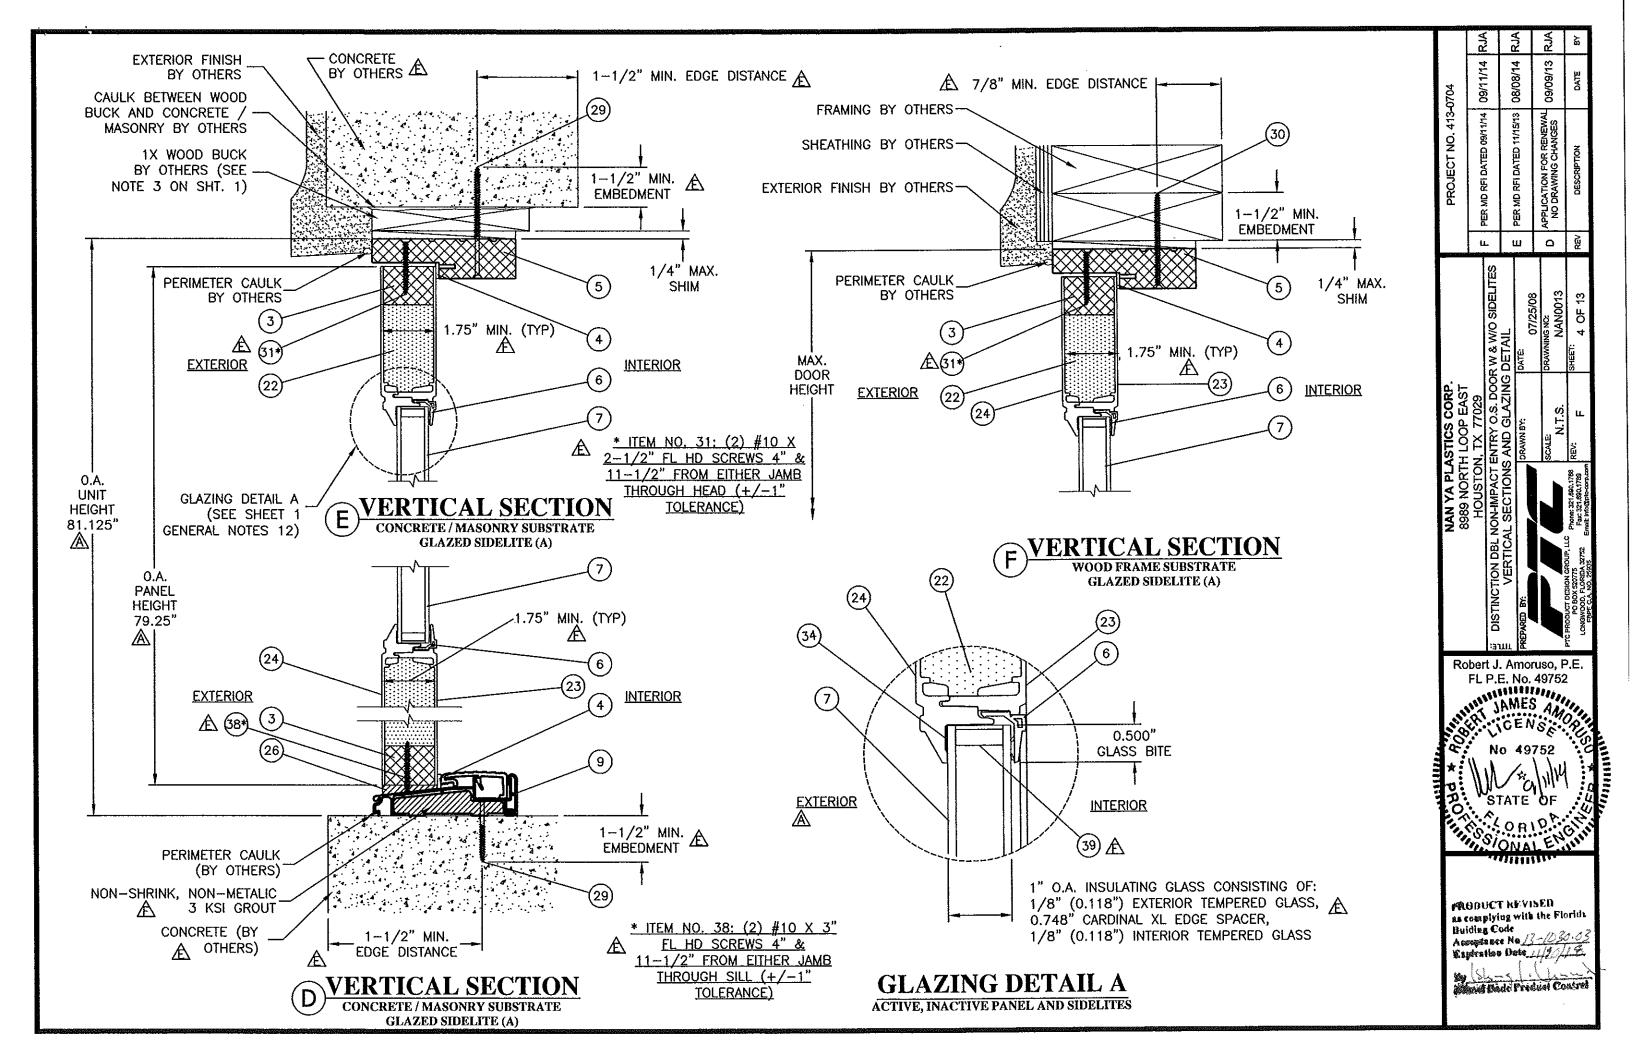


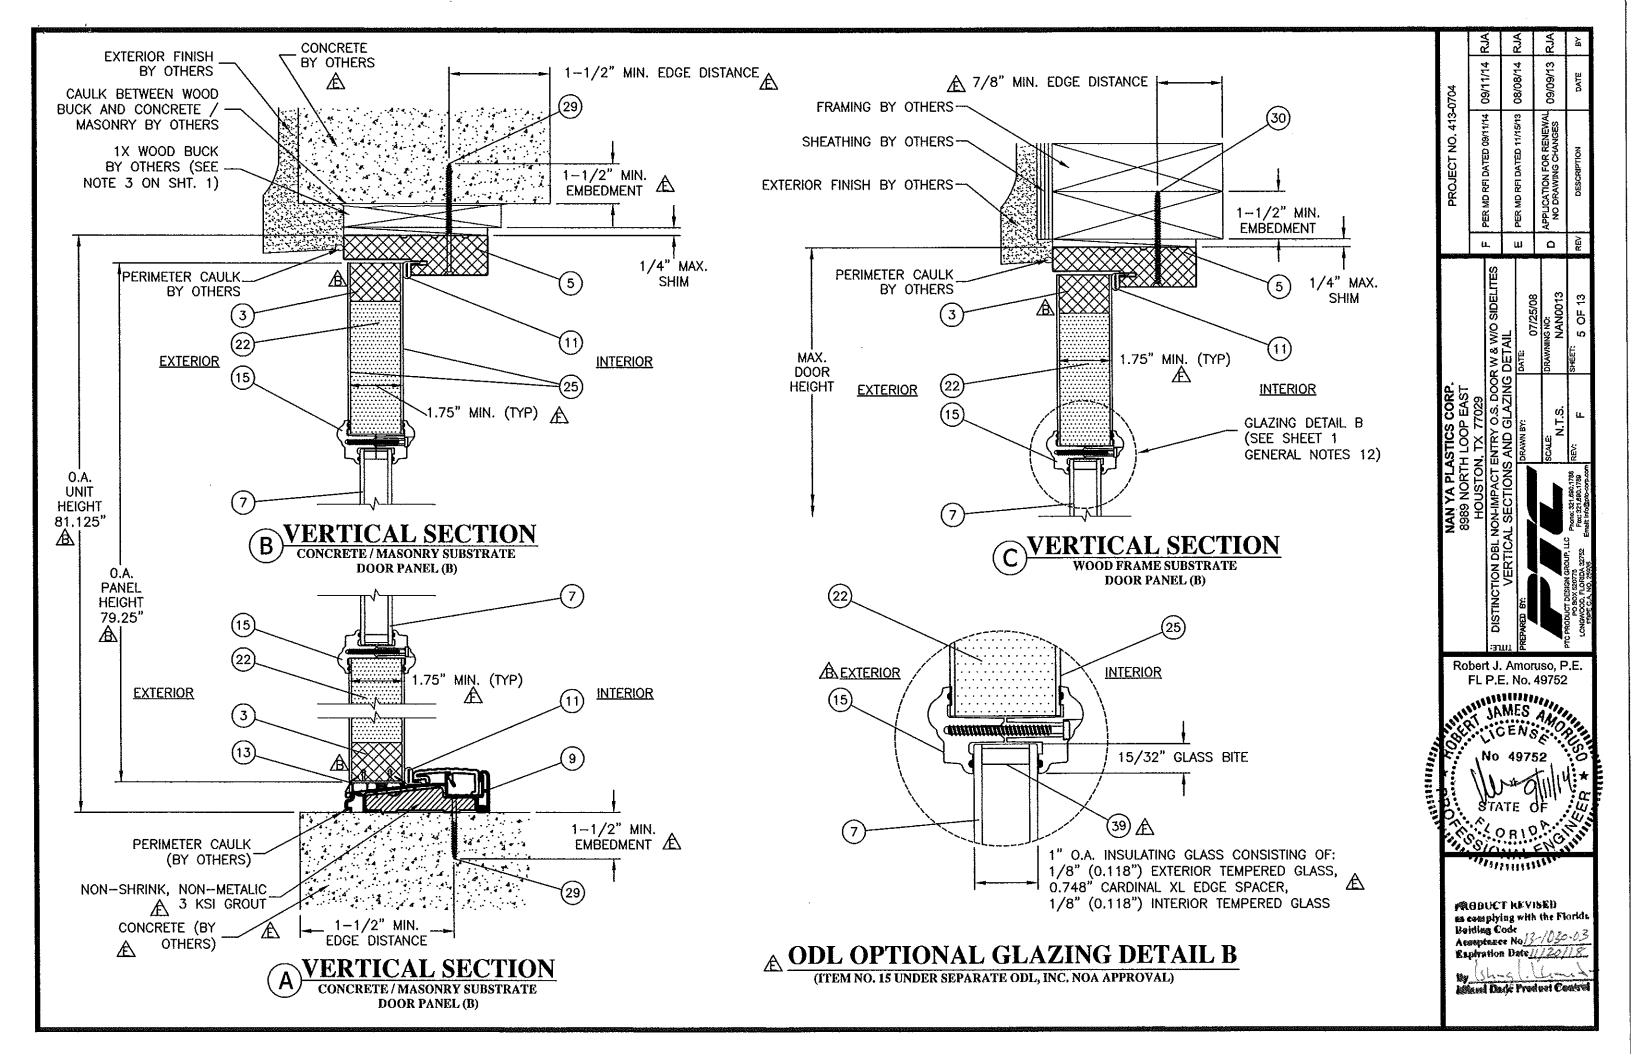


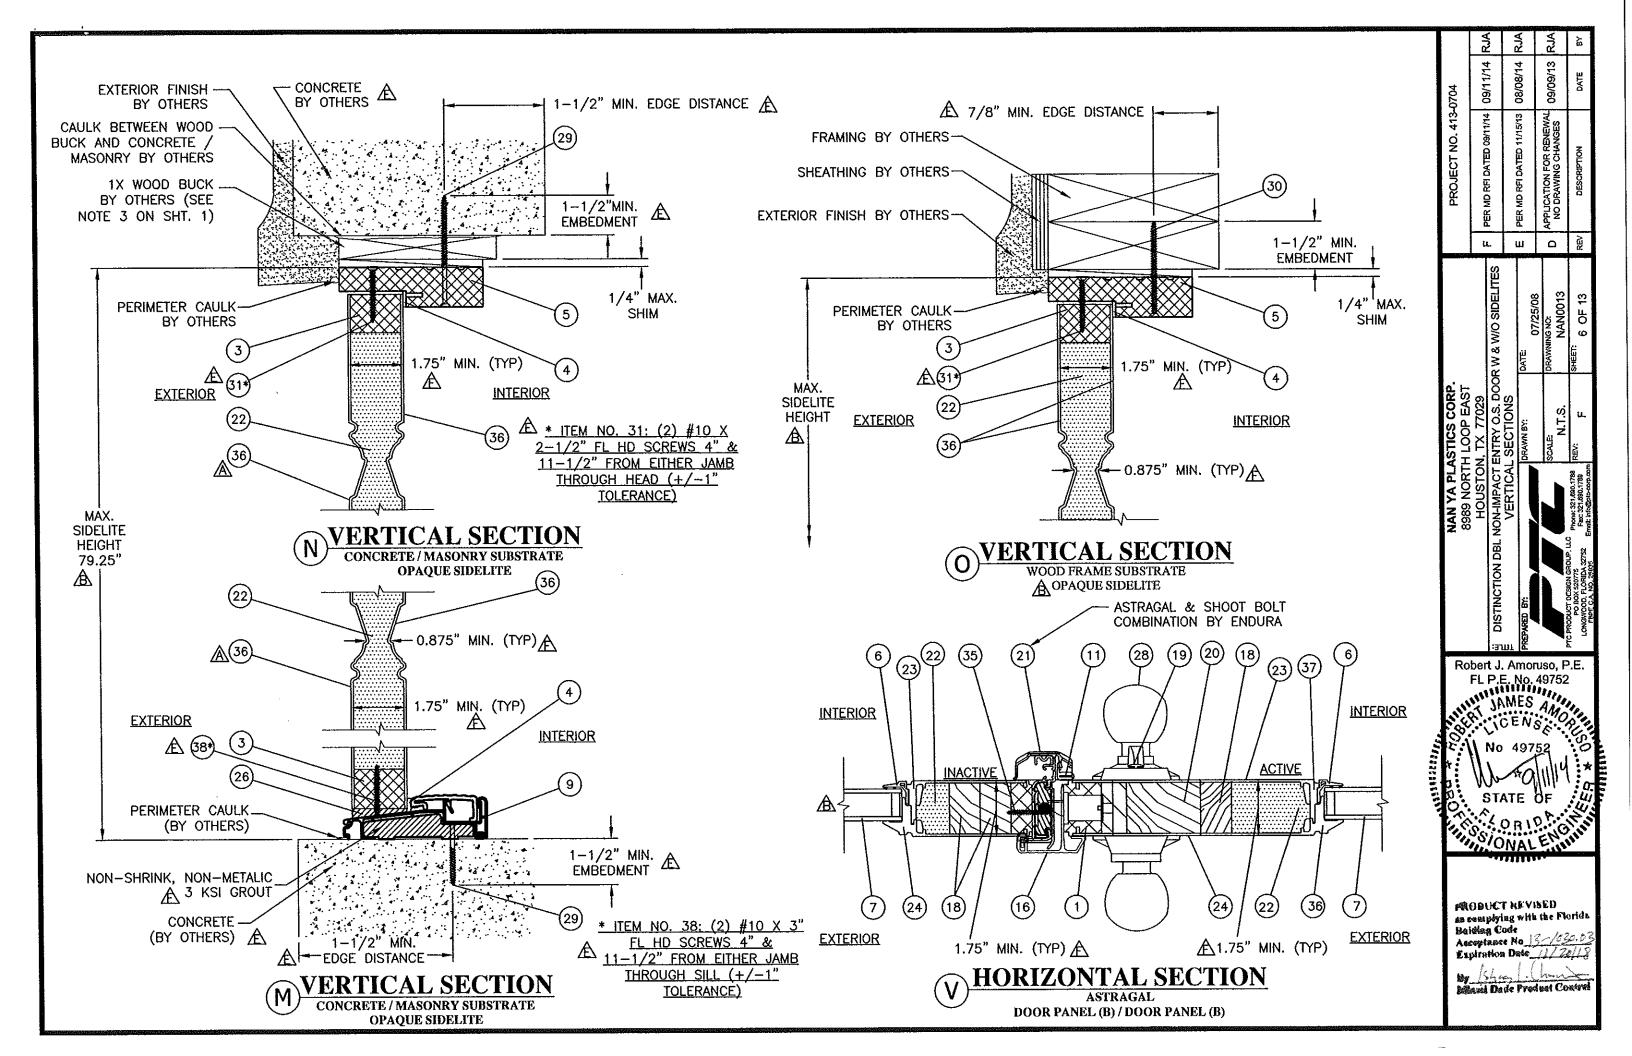

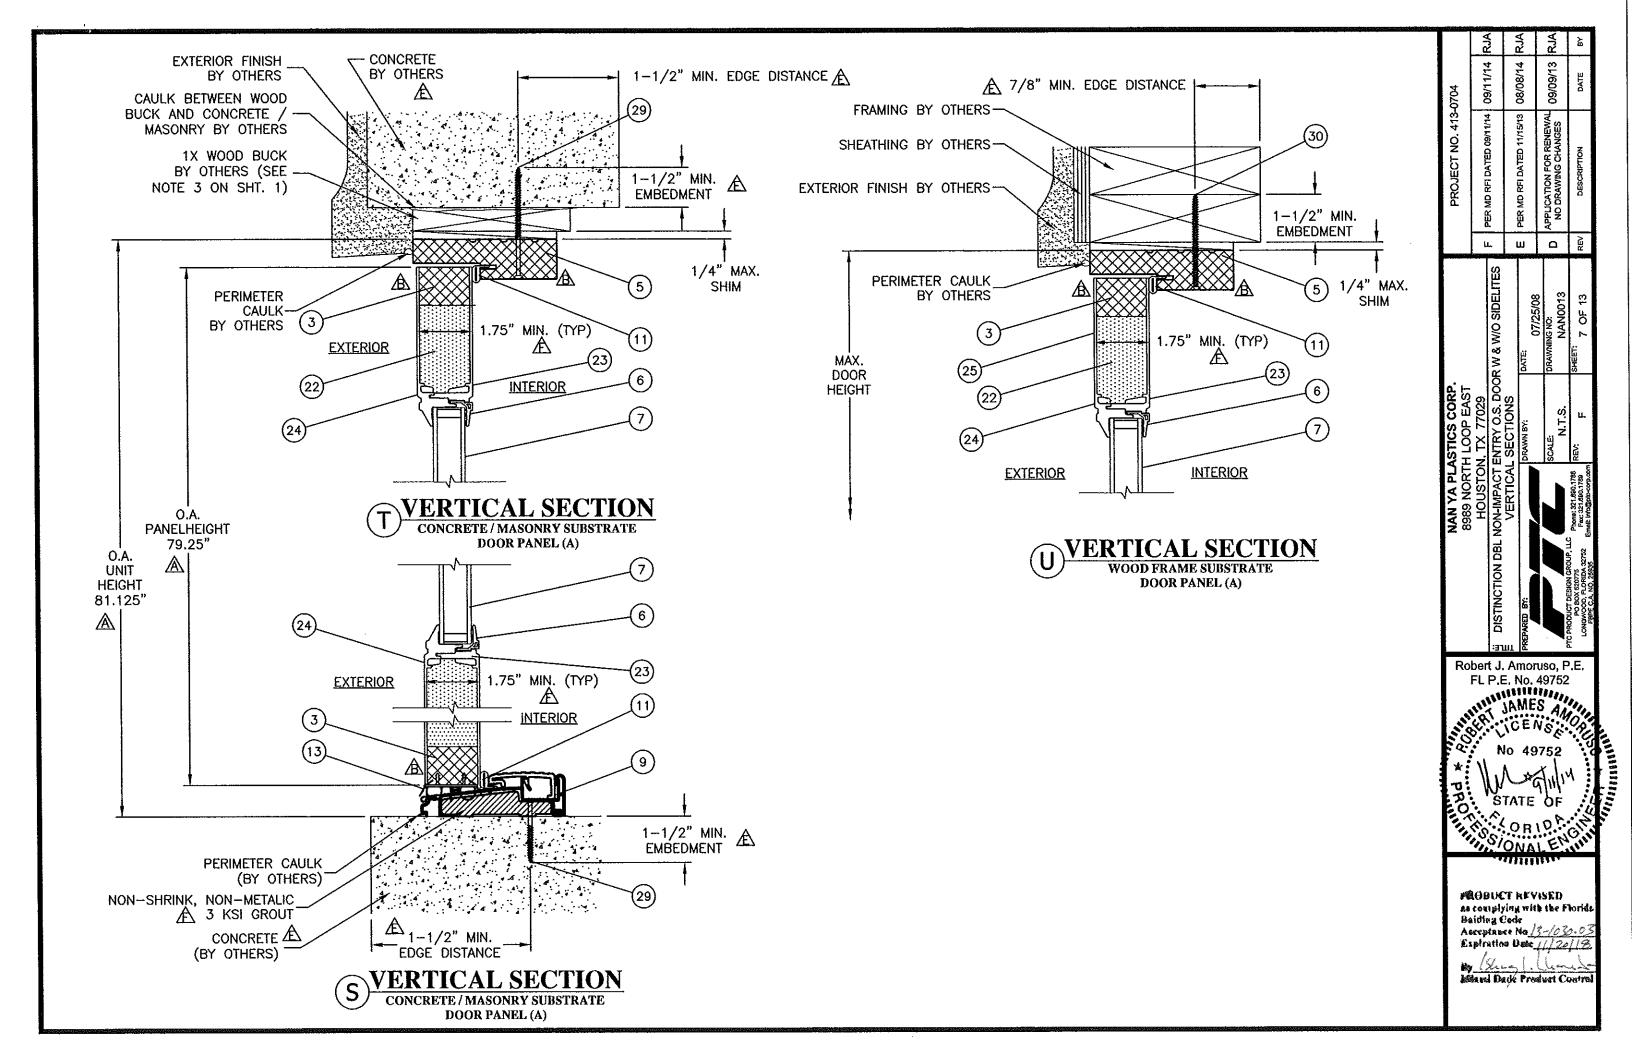

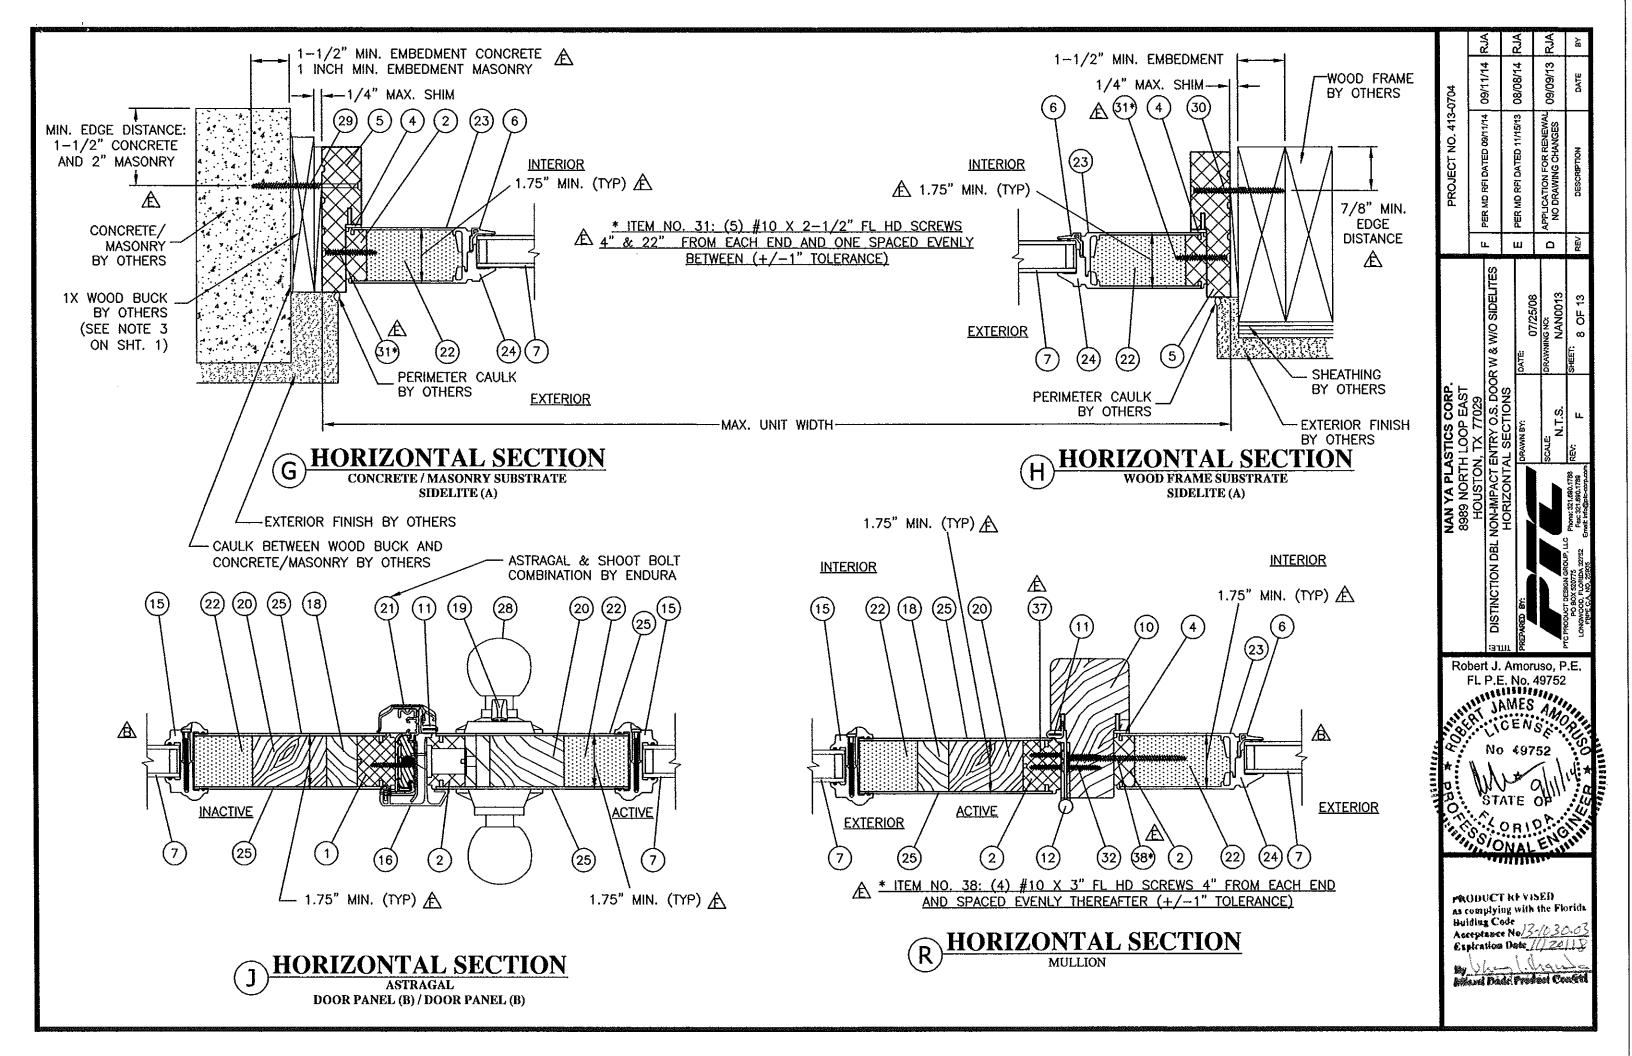

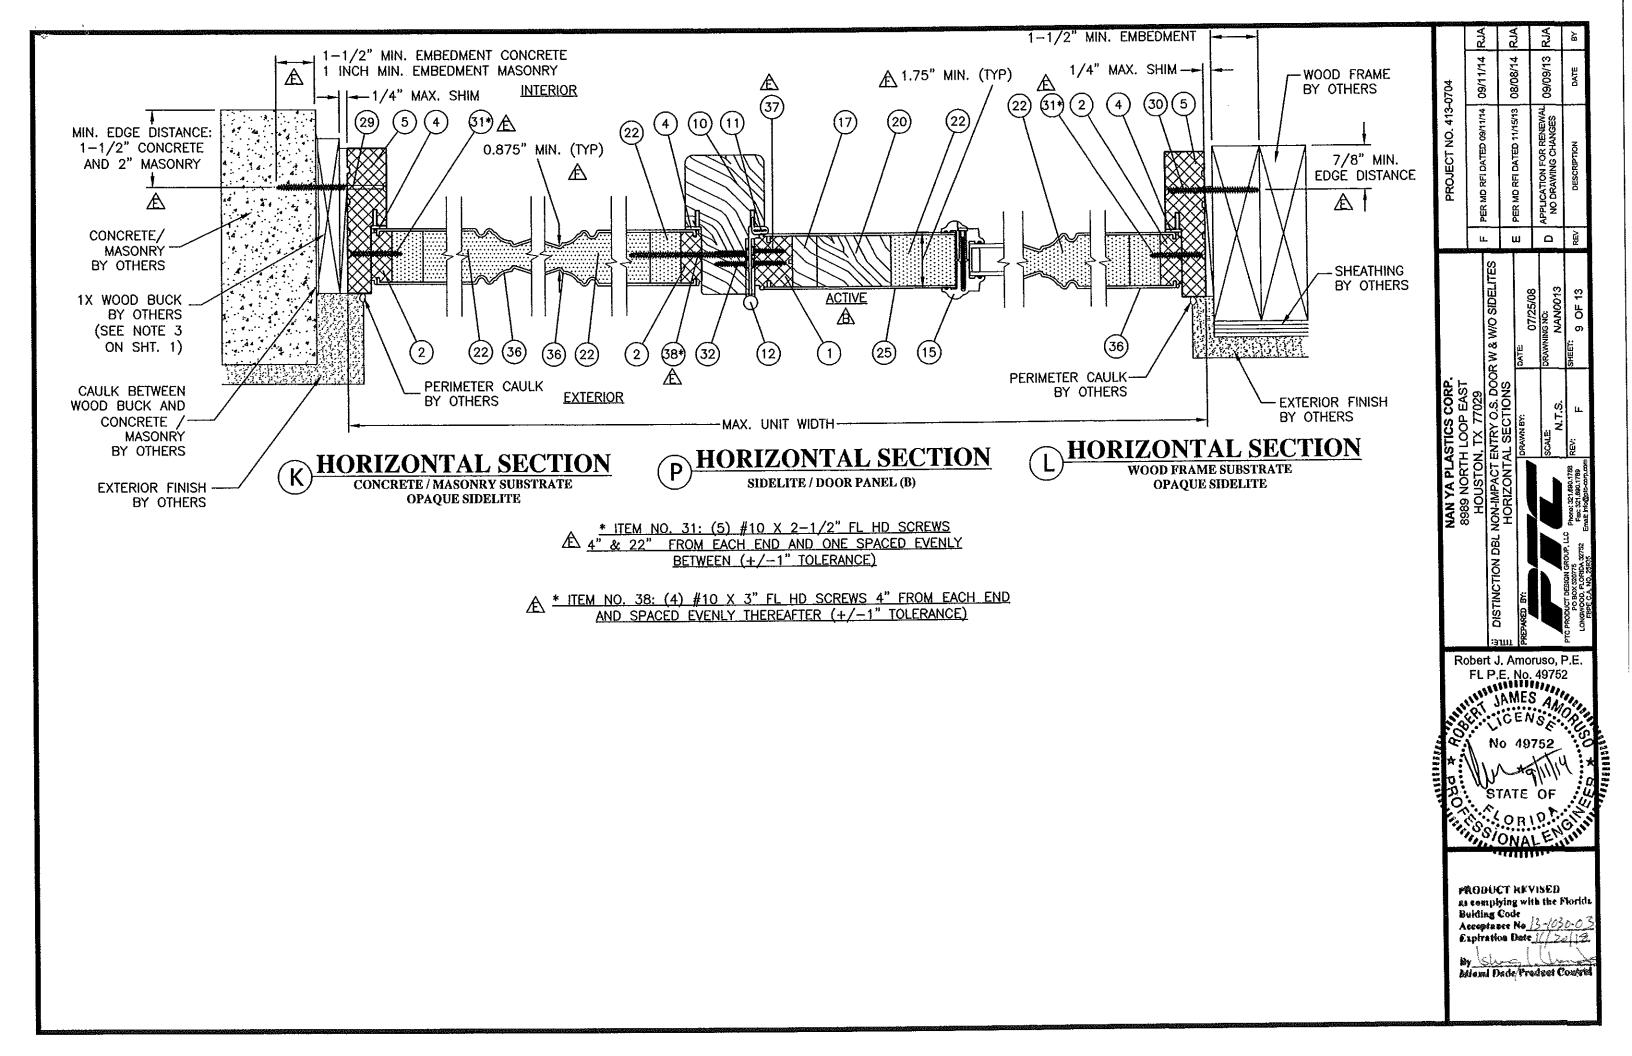

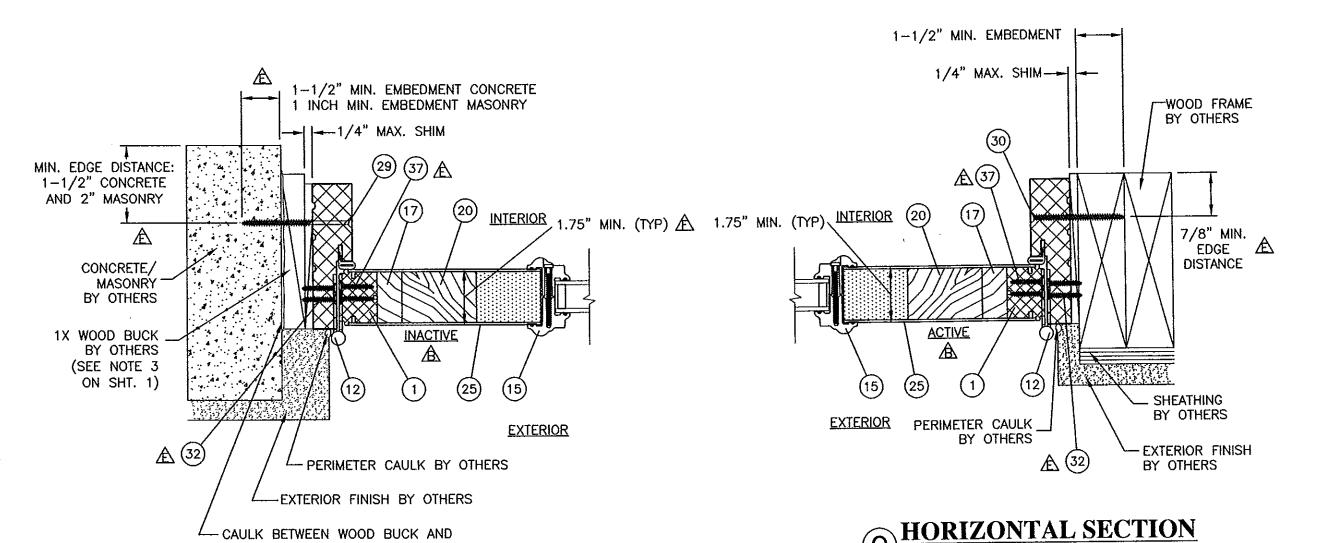

CAULK BETWEEN WOOD BUCK AND CONCRETE/MASONRY BY OTHERS

> CONCRETE / MASONRY SUBSTRATE GLAZED DOOR PANEL (B)

	ļ ļ	<u> </u>	4	0	-	_	U.		l
	-0704	09/11/14	1 1 1 1 1 1 1 1 1 1 1 1 1 1 1 1 1 1 1 1	V 100100	00/00	L	09/09/13 R	DATE	
	PROJECT NO. 413-0704	Page 100 per per per per 1/14 P			PER MD RFI DATED 11/13/13 06/00/14 R		D APPLICATION FOR RENEWAL NO DRAWING CHANGES	DESCRIPTION	
		£	_	ا	IJ		Ω	Æ	
			DISTINCTION DBL NON-IMPACT ENTRY O.S. DOOR W & W/O SIDELITES		DATE:	90/07//0	DRAWNING NO: NANO013	SHEET: 10 OF 13	
	NAN YA PLASTICS CORP.	HOUSTON, TX 77029	T ENTRY O.S. DOO!	HORIZONTAL SECTIONS	DRAWN BY:		SCALE: N.T.S.	REV: F	
	NAN YA P	HOUST	ON DBL NON-IMPAC	HORIZON				1 GROUP, LLC Phone; 321,690,1788 775 Fax: 321,690,1789 110A 32752 Famil: Info@ole-com.com	
	D	, ha	:3	ШТ				PTC PRODUCT DESIGN GROUP, LLC PO BOX 620775 LONGWOOD, PLORIDA 22752 PLONGWOOD, PLORIDA 22752 PLORIDA	02. C. C. C
	R						iso, l 1975:	2	
	.,	11/1	issi L	AN	NES	3	Ani	100	
	100	<i>\</i>	V	Ċ	Ē٨	i	E	18/50 18/50 18/50	4
į	2		N	0	49 /	7: \	52 \\		
	lg.	$/\!\!/$	$\tilde{h}_{\gamma}$	ГА	<i>የነብ</i> r =	Ņ	/////  ////		
	10		<u>`</u> ر	0	r. P.¹	, <	96.	N	
	130	, O,	Sį.	à	44		EN	1111	4
		<b>9</b> 0	. 12~	~ • • •	121) 121)	g ¥	ED		
	23 ( Qu	esa in e	ply a C	gui odu	witi	<b>h</b> 1	he Fi	oridi *- ^ 2	
	Ac	eeu pire	12	e N	lo	2 4	·/0_5		
	助始		I D	e de	Pre	d	en C	HI THE	
						en e	a constitutada (	San Harana	

WOOD FRAME SUBSTRATE GLAZED SIDELITE (A)

ſ	ITEM NO.	OLIANTITY	DESCRIPTION	MATERIAL.	VENDOR
Ì	1	3	1 5/32" STILE	FOAM PVC	NANYA PLASTI
ł	2	8	5/8" STILE	FOAM PVC	NANYA PLASTK
}	3	1	1 3/4" TOP/BOTTOM RAIL INSERT	FOAM PVC	NANYA PLASTIC
A	4	AS REO'D	SILICONE SEALANT	TYPE 1199	DOW CORNING
45	5	3	FRAME HEAD & JAMB	FOAM PVC	NANYA PLASTI
ŀ	6		1" GLAZING BEAD	RIGID PVC	NANYA PLASTI
	7	No reg D.	1/8" (0.118") TEMPERED GLASS, 0.748" CARDINAL XL EDGE SPACER, 1/8" (0.118") TEMPERED GLASS	GLASS 🛕	CARDINAL
1	8		A	A 410 (0)10 ( D)/O	ENDUDA
1	9	3	SILL ASSY.	ALUMINUM, PVC	ENDURA
	10	2	MULLION - PINE WITH ROT PROOF COMPOSITE MATERIAL AT SILL END A	WOOD / COMPOSITE A	ENDURA Q-LON
	11	AS REQ'D.	Q-LON 650 WEATHERSTRIPPING	FOAM SILICONE PE FILM	
	12	4	4" X 4" HINGE	STEEL	MICOTA
	13	2	DOOR SWEEP	RIGID PVC CO-EX	ENDURA
	14	2	CORNER PAD	FOAM SILICONE PE FILM	ODL
	15	AS REQD.	ODL NON-IMPACT GLAZED INSERT KIT SYSTEM (PER CURRENT NOA)	HP POLYPROPYLENE Æ	
	16	2	OUTSWING PANEL TRIM A	ALUMINUM, PVC	ENDURA 
	17	2	WOOD REINFORCEMENT 4	WHITE PINE S.G. = 0.40 MIN.	
	18	2	WOOD REINFORCEMENT 🕰	WHITE PINE S.G. = 0.40 MIN. A	KWIK-SET
	19	11	DEAD BOLT-KEYED		
	20	2	WOOD REINFORCEMENT A	WHITE PINE S.G. = 0.40 MIN. Æ	ENDURA
	21	1	HURRICANE ASTRAGAL (INCLUDING FLUSH BOLTS)	ALUMINUM, STEEL, PVC	NANYA PLAST
	22	AS REQD.	POLYURETHANE FOAM	FIBERGLASS SKIN A	
	23	2	SMC S12P GLAZED SIDELITE SKIN — MALE 🛕	Fy MIN = 11,000 PSI ABA	NANYA PLAST
	24	2	SMC S14P GLAZED SIDELITE SKIN — FEMALE A	Fy MIN = 11,000 PSI 783	NANYA PLAST
	25	2	SMC OOP DOOR SKIN A	Fy MIN = 11,000 PSI 283	NANYA PLAST
	26	1	SIDELIGHT BASE SUPPORT	RIGID PVC CO-EX A	NANYA PLAST
	27	11	1 3/16" X 1 19/32" WOOD REINFORCEMENT 🕰	WHITE PINE S.G. = 0.40 MIN.	KWIK-SET
	28	1	DOOR KEYED ENTRY LATCH SET	OADDON STEEL A	ITW A
	29 4	AS REQ'D	1/4" ITW ADVANCED THREADFORM TAPCON Æ	CARBON STEEL A	11W /B)
			#12 X 3" PH FL HD SCREW	STEEL	<del> </del>
	31		#10 X 2 1/2" PH FL HD SCREW	STEEL	
	32	12	#10 X 1 1/2" PH FL HD SCREW	STEEL	
	33	14	#10 X 1" PH FL HD SCREW	STEEL	DOW CORNII
	34		DOW CORNING 995 SILICONE SEALANT	SILICONE	DOW CORN
	35		#8 X 1" PH FL HD SCREW	FIBERGLASS SKIN A	NANVA DIACT
	36	2	SMC 14P DOOR OPAQUE SKIN	Fy MIN = 11,000 PSI ZBS	NANYA PLAST
Å	37	24	#10 X 2" PH FL HD SCREW	STEEL	
	38	24	#10 X 3" PH FL HD SCREW	STEEL	

	.04	9/11/14 RJA		A1 G 1700/0	10000 T		9/09/13 RJA	DATE BY	
	PROJECT NO. 413-0704	BER MD REI DATED 09/11/14 BJA		C NO NEW COLOR	PER MU RFI DATED 127913 GOOGLE 14		APPLICATION FOR RENEWAL 09/09/13 RJA NO DRAWING CHANGES	DESCRIPTION	
Į		U	-	ļ	ij		٥	REV	Ì
			TINCTION DBL NON-IMPACT ENTRY O.S. DOOR W & W/O SIDELITES		DATE	90/07//0	DRAWNING NO: NANOO13	SHEET: 11 OF 13	
	NAN YA PLASTICS CORP.	HOUSTON, TX 77029	ENTRY O.S. DOOF	BILL OF MATERIALS	DRAWN BY:		SCALE: N.T.S.	REV:	
	NAN YA PL	HOUSTO	BL NON-IMPACT	BILL OF				2, LLC Phone; 321,690,1788 Fax; 321,690,1789 Email: Info@pto-corp.com	
			DISTINCTION D	<b>У</b> ПТ (	PREPARED BY:			PTC PRODUCT DESIGN GROUP, LLC PO BOX 620775 LONGWOOD, PLORBAD 32752	COLOR COLOR
	Ro	FL.	Pいじい	AN C	No NES E N	4	1975 A/V	_	
<b>日本日本の日本日本日本日本日</b>	V PAOX		N V S S S	 ΓΑΤ	49°	パイソーバ	OF A	N. S.	A HOUSE
	a M	MO Seed	eg Ka	lyla Co see	g w te No	H		Florid 30.0	, W

By Shara ( Legal Dade Product Control

